VAR	MODEL	CUSTOMER	CAT. NO.	A	B	C	D	HP	VOLTS	SF	AMPS	HZ	RPM	CONN VOLTS	PROT.	DESCRIPTION / REMARKS
~~001~~	~~T63GRS-2201~~	~~USEM~~	~~D32GP1PCR~~	~~12.388~~	~~-------~~		~~3.915~~	~~1.5~~	~~115/230~~	~~1.15~~	~~13.3/6.7~~	~~60~~	~~3450~~		~~NONE~~	~~N56C, ODP~~
002	T63CXCSG-2214	USEM	D1CPA1PCR	12.89	-------	-------	3.915	1.0	115/230	1.25	9.3/4.3	60	3450	-----	AUTO	N56C, ODP

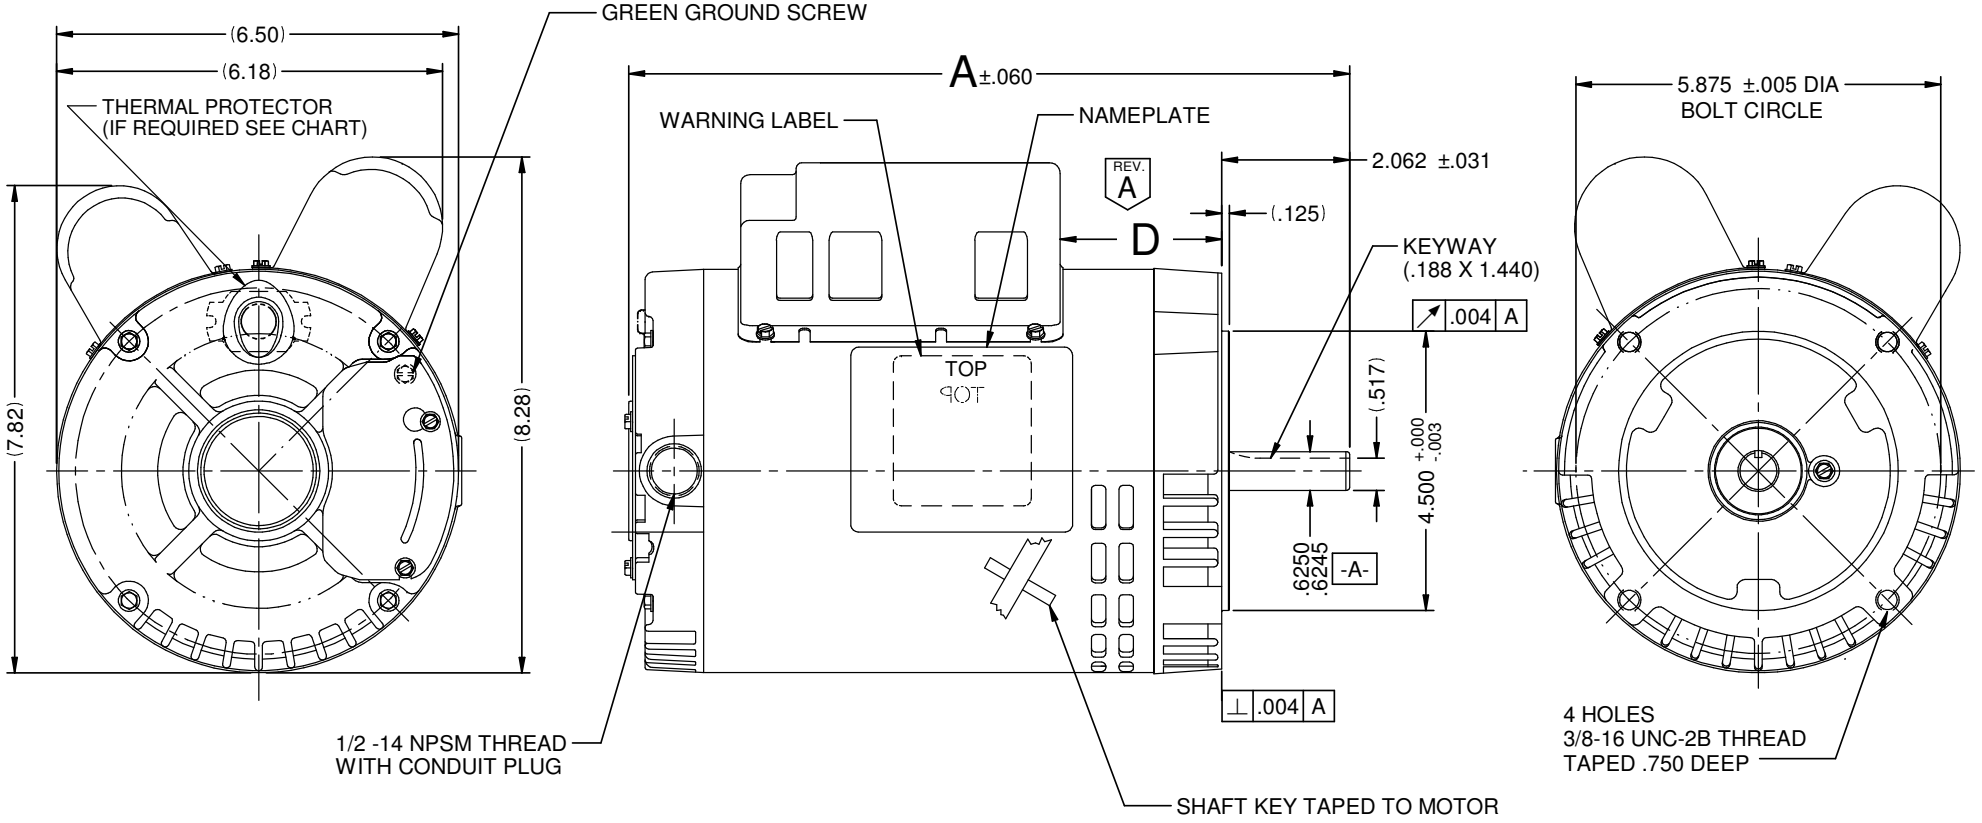

NIDEC MOTOR CORPORATION 21-Oct-15

MOTOR IS CCW ROTATION LEAD END, TO REVERSE ROTATION INTERCHANGE RED AND BLACK LEADS.

REFER TO S.E.I.M. 24-1

REVISION RECORD FOR: E23969

ADDED DIMENSION 'D' FOR LOCATION OF CAP COVER, CRITICAL REQ. #6 & #7 AND PAGES 5 & 6
OBSOLETED VAR. 001 IN DRAWING BECAUSE EXIST IN V02804786.

ISSUED BY : A. DEL ANGEL

ENGINEER APPROVED : W. GARZA

TOLERANCES ON DIMENSIONS (UNLESS OTHERWISE SPECIFIED)

INCHES .XX = ± .010 .XXX = ±.005

mm

ANGLES X°= ±1°

NIDEC MOTOR CORPORATION

INFORMATION DISCLOSED ON THIS DOCUMENT IS CONSIDERED PROPRIETARY AND SHALL NOT BE REPRODUCED OR DISCLOSEDWITHOUT WRITTEN CONSENT OF NIDEC MOTOR CORPORATION

REVISION DATE : 08-OCT-15

TITLE	CODE	ITEM NO.	REV	SHEET NUMBER	DWG SIZE
CUSTOMER DETAIL DRAWING	V02	804919	A	1 OF 6	B